
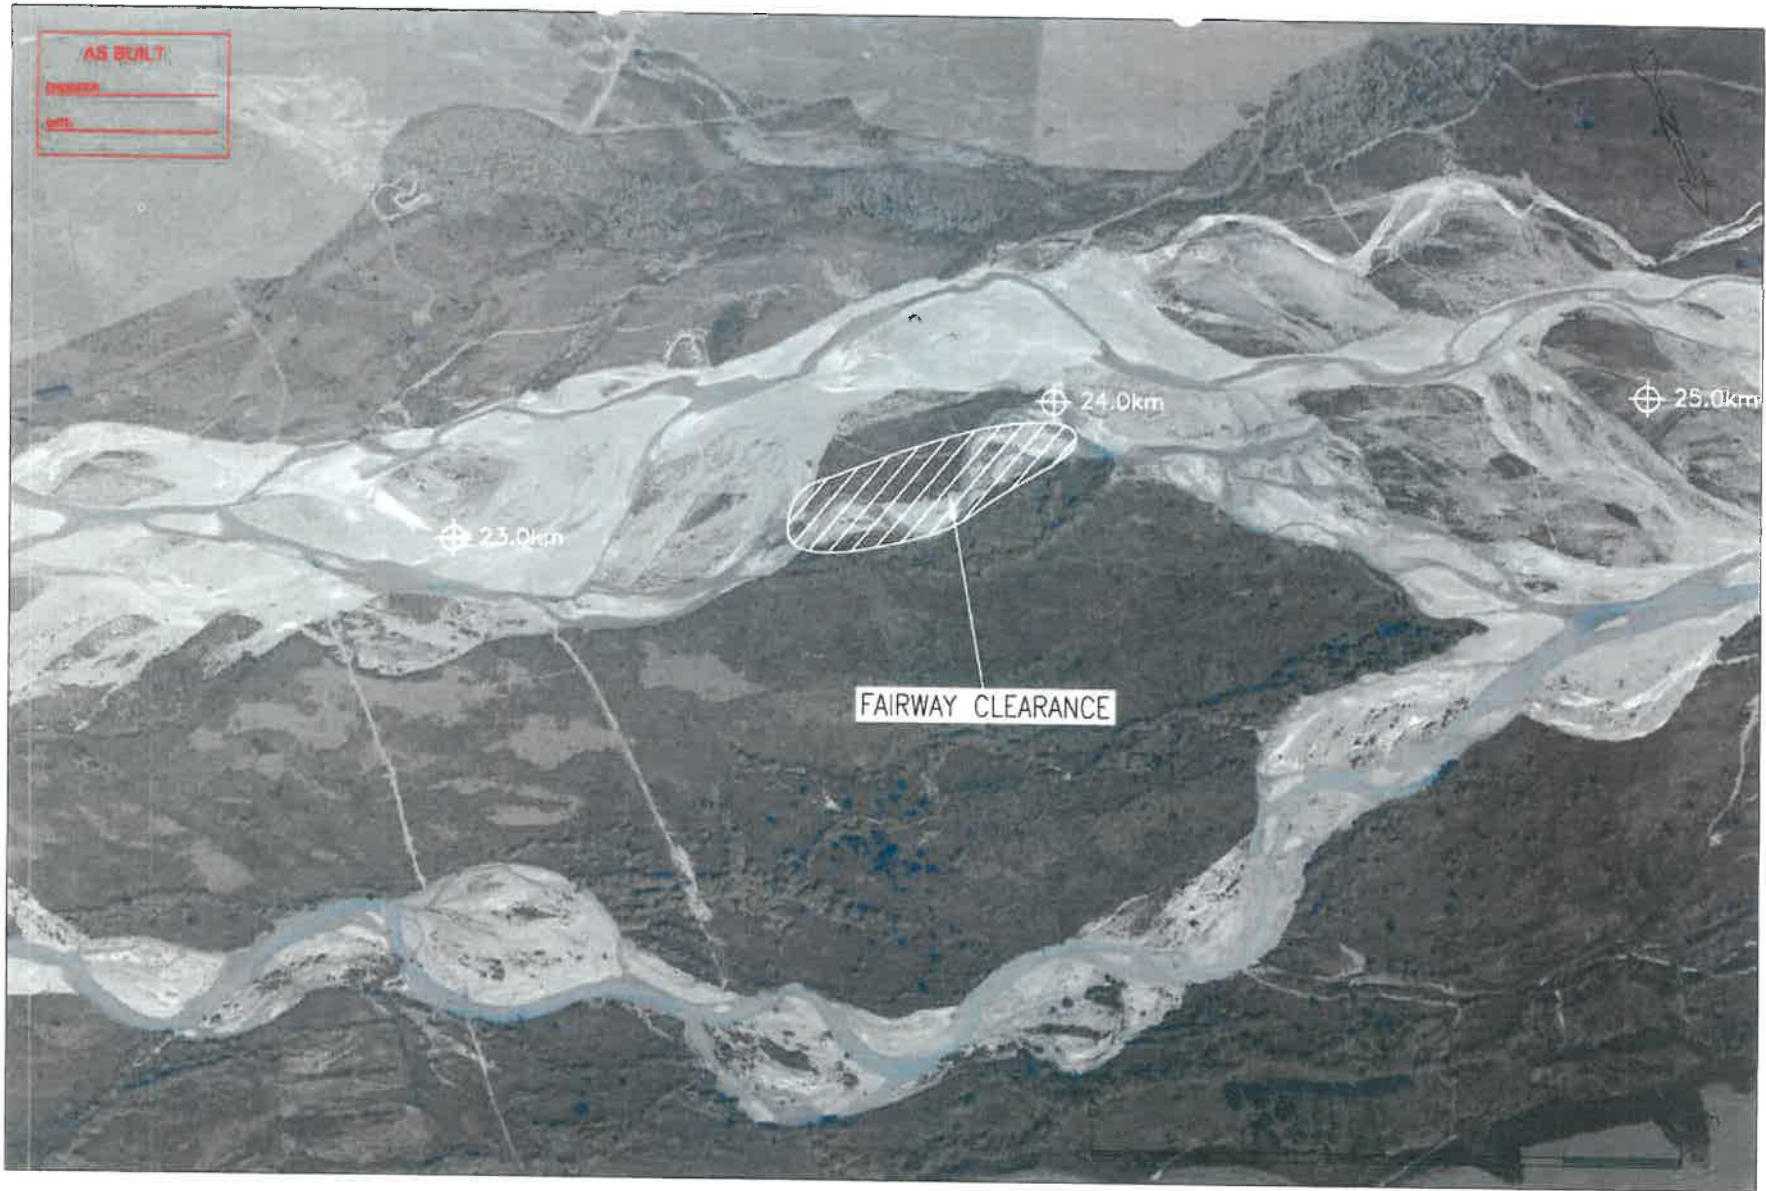


WI	Amendments	Aerial Photo	S.N.264 A/2	2/08	 Environment Canterbury Your Natural Future	Environment Canterbury	Catch No. 6930000 File No. Surv Data 13,515m01 1 of 30
	PLAN ORIGIN	Base Sheet	N.F. Daniels	2/08		Rating Districts Works Programme 2009/2010 Rangitoto River	
E	COORDS	Surveyed					
E		Designed					
		Compiled					
		Checked					
		Recommended					



AS BUILT


23.0km

24.0km


25.0km




FAIRWAY CLEARANCE


W12	Amendments	Aerial Photo	S.N.264 A/30	2/08	 Environment Canterbury Your regional council	Environment Canterbury Rating Districts Works Programme 2009/2010 Rangitata River		Catch No.	6930000
	PLAN ORIGIN	COORDS	Surveyed				File No.		13,515m12 12 of 30
E	N	E	Designed			Surv Data			
			Compiled	N.F. Daniels	2/08	Original Scale	1:8000	Level Datum	
			Checked						
			Recommended						


805 PAN

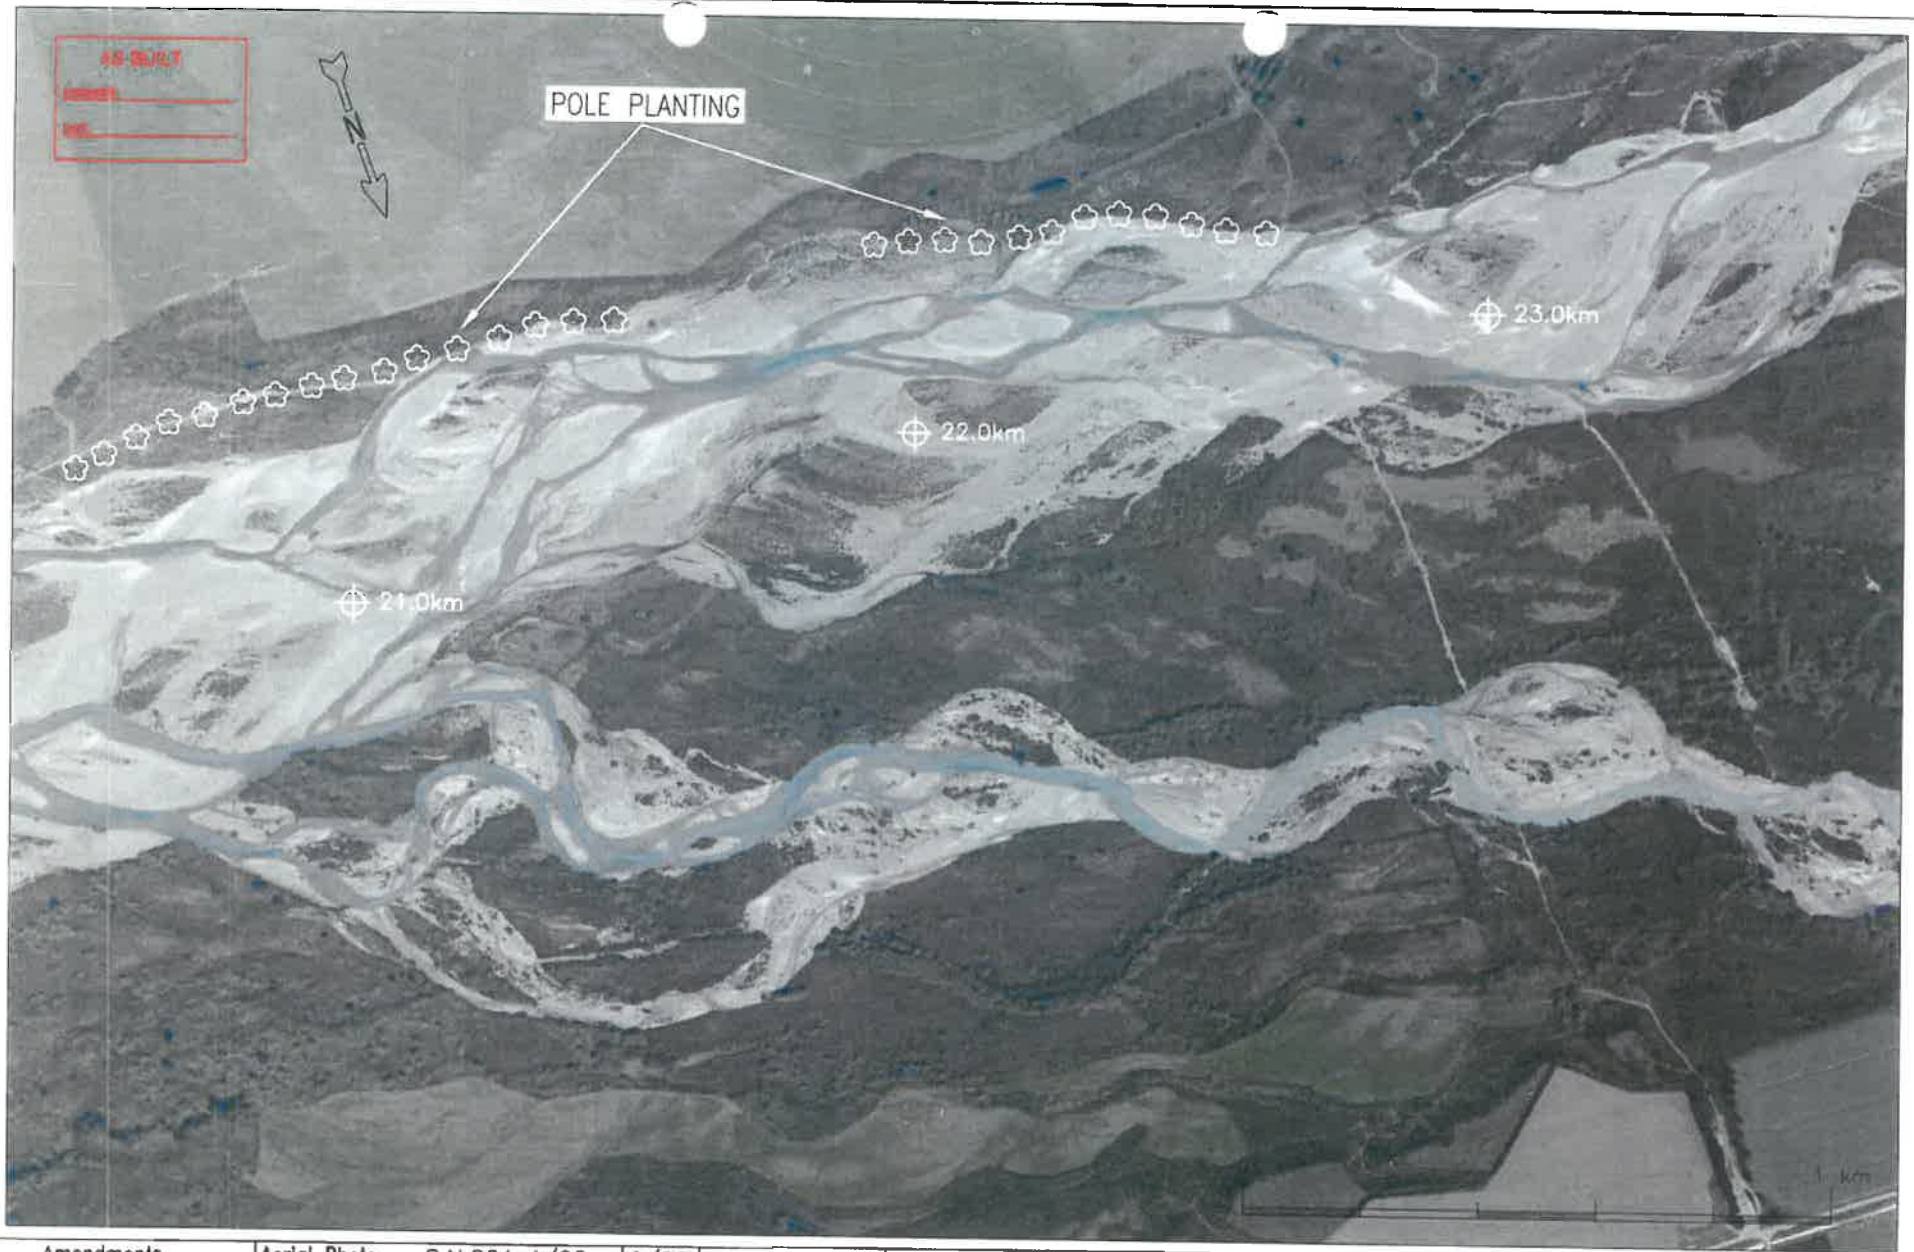

W11	Amendments	Aerial Photo	S.N.264 A/28	2/08	 Environment Canterbury	Environment Canterbury	Catch No. 6930000 File No. Surv Data 13,515m11 11 of 30
	PLAN ORIGIN COORDS	Base Sheet	N.F. Daniels	2/08		Rating Districts Works Programme 2009/2010 Rangitata River	
		Surveyed				Original Scale 1:8000	Level Datum
		Designed					
		Compiled					
		Checked					
		Recommended					

BOE RAN

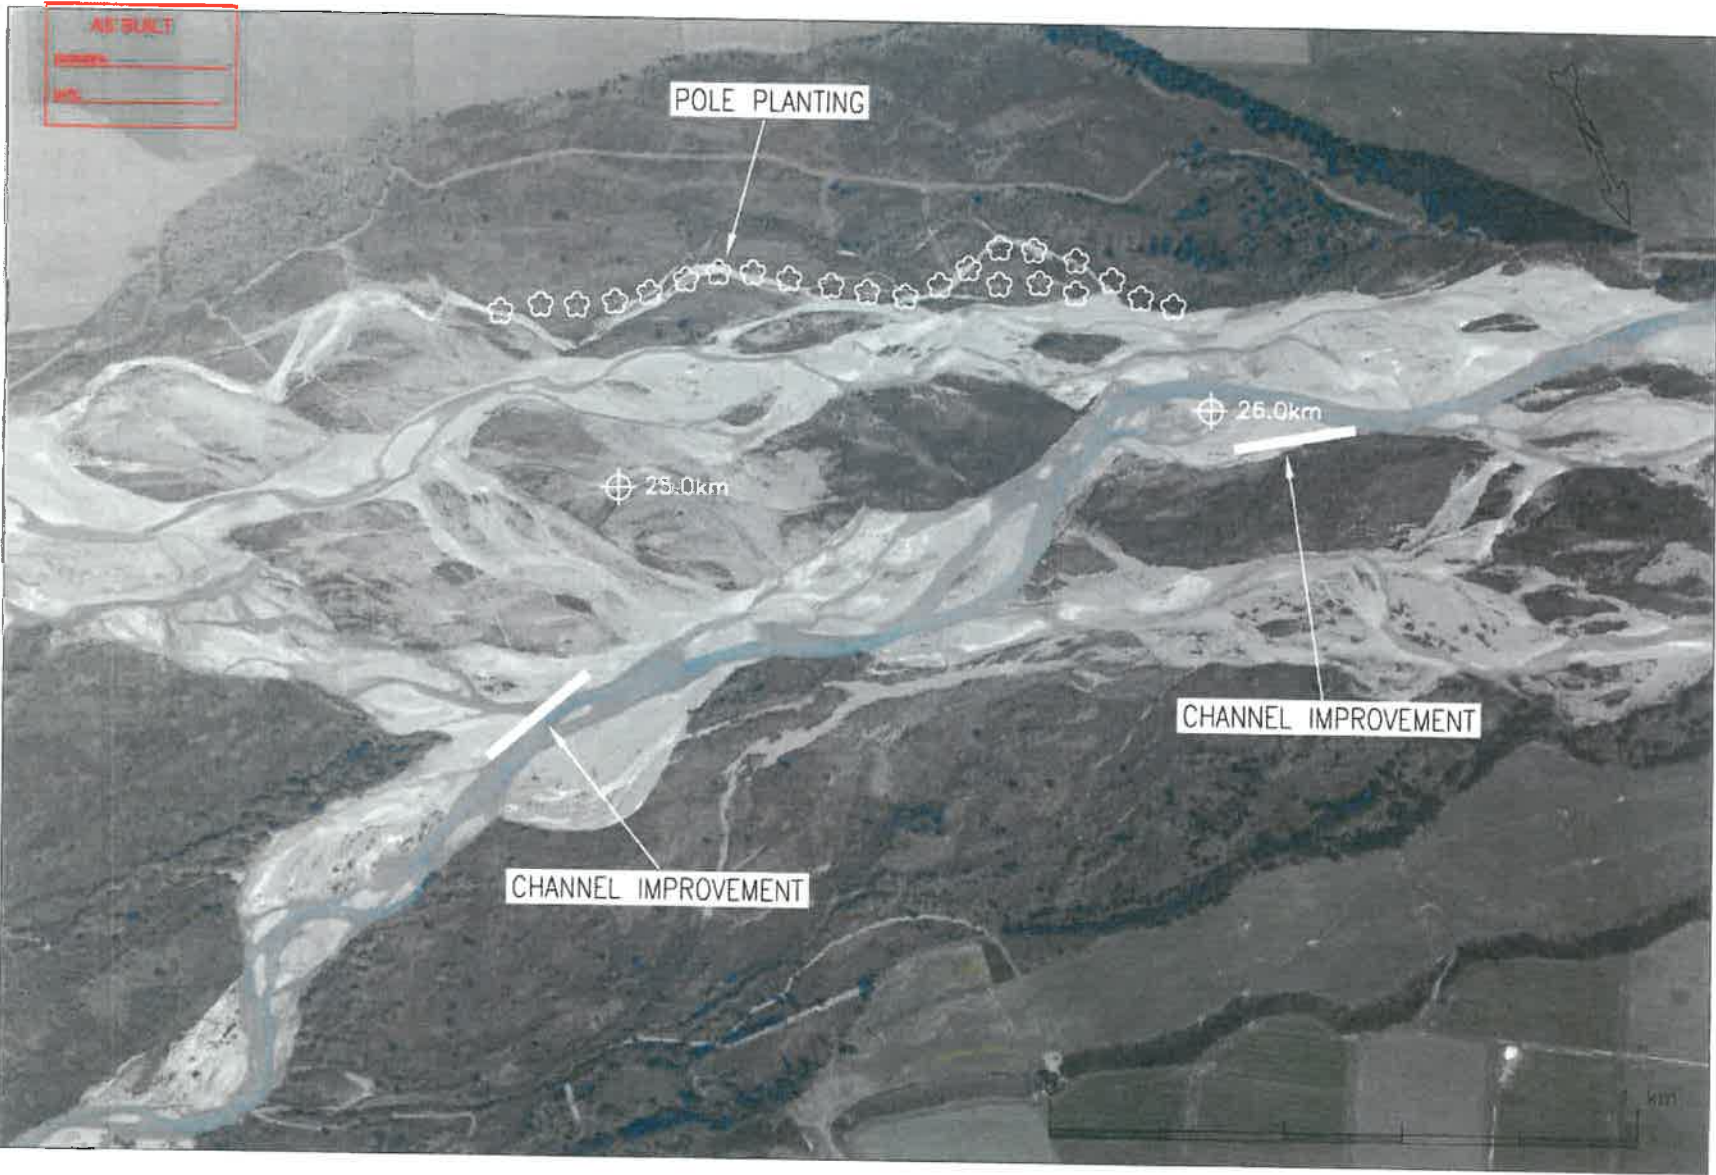

W13	Amendments	Aerial Photo	S.N.264 A/32	2/08	 Environment Canterbury Your regional authority	Environment Canterbury	Catch No. 6930000 File No. Surv Data 13,515m13 13 of 30
	PLAN ORIGIN COORDS	Base Sheet	N.F. Daniels	2/08		Rating Districts Works Programme 2009/2010 Rangitata River	
		Designed					
		Compiled					
		Checked					
		Recommended					

804 PAN.