
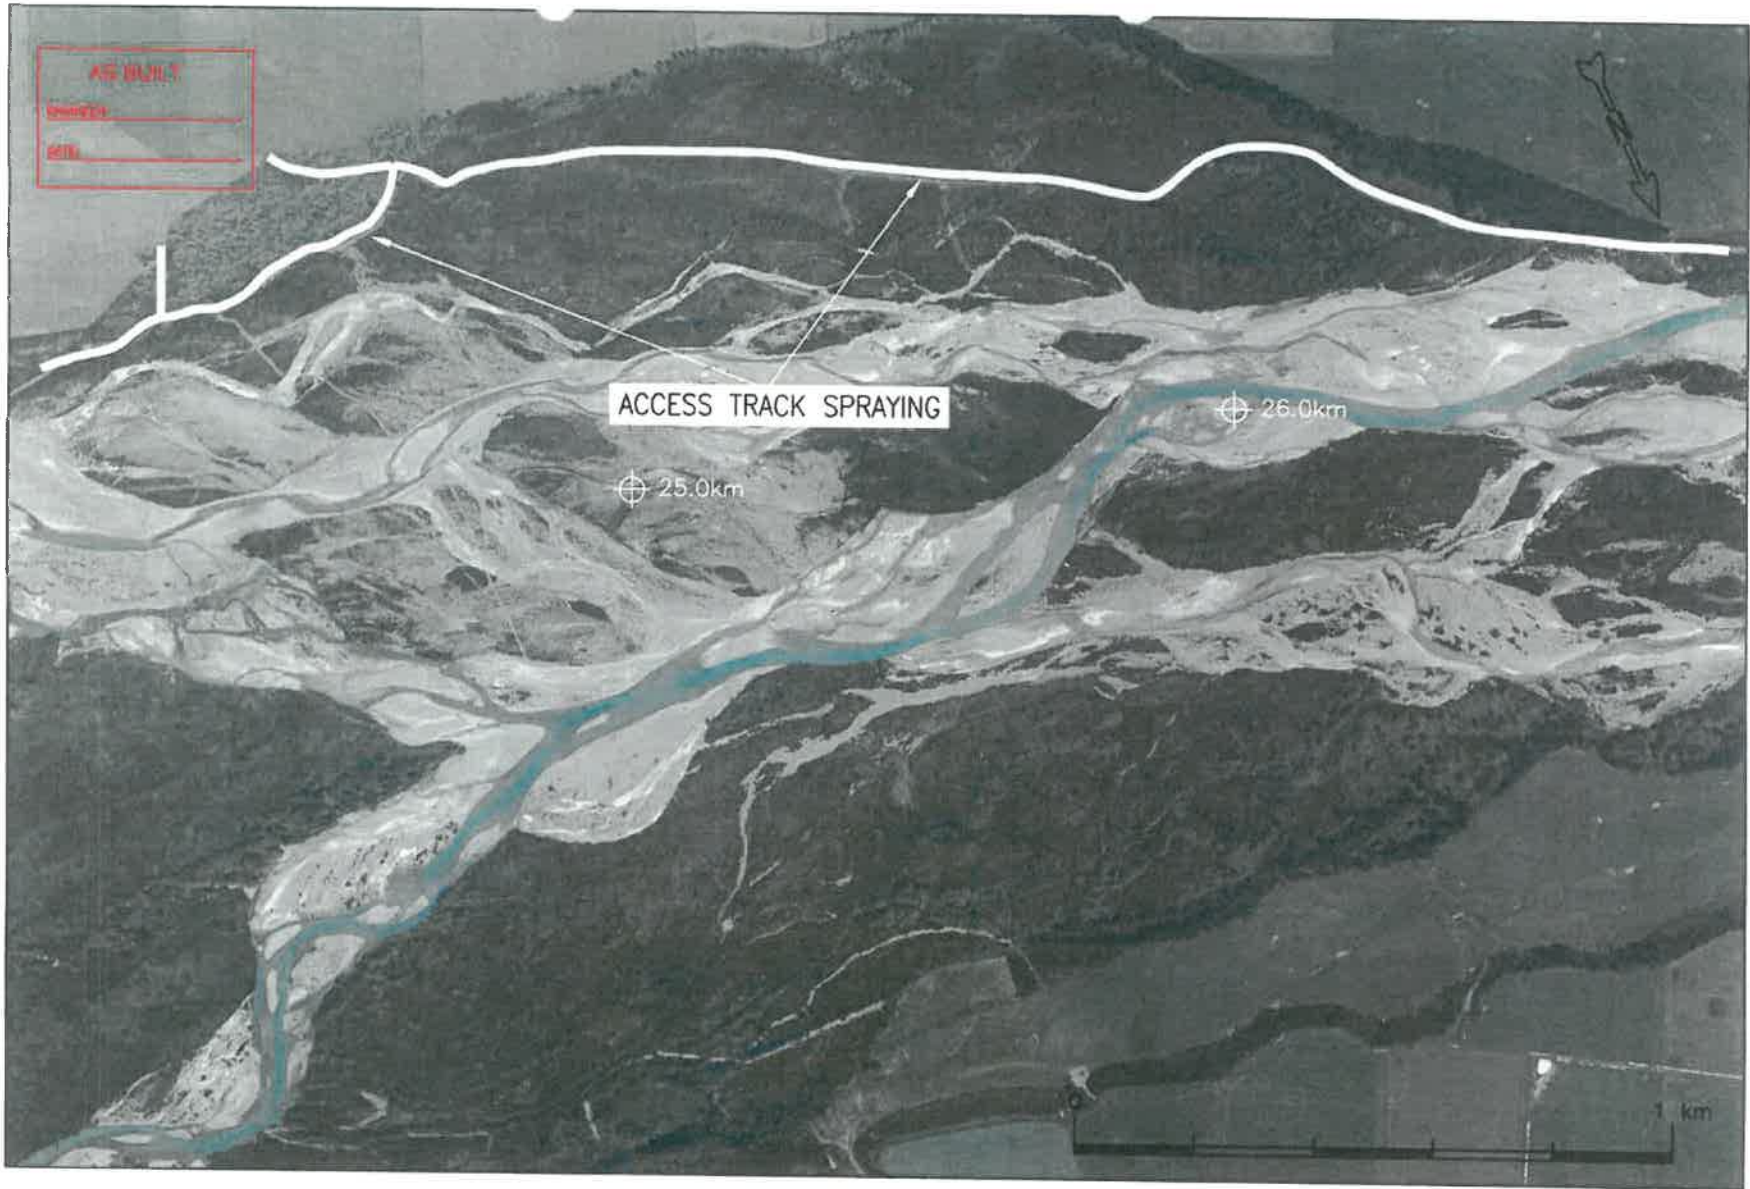

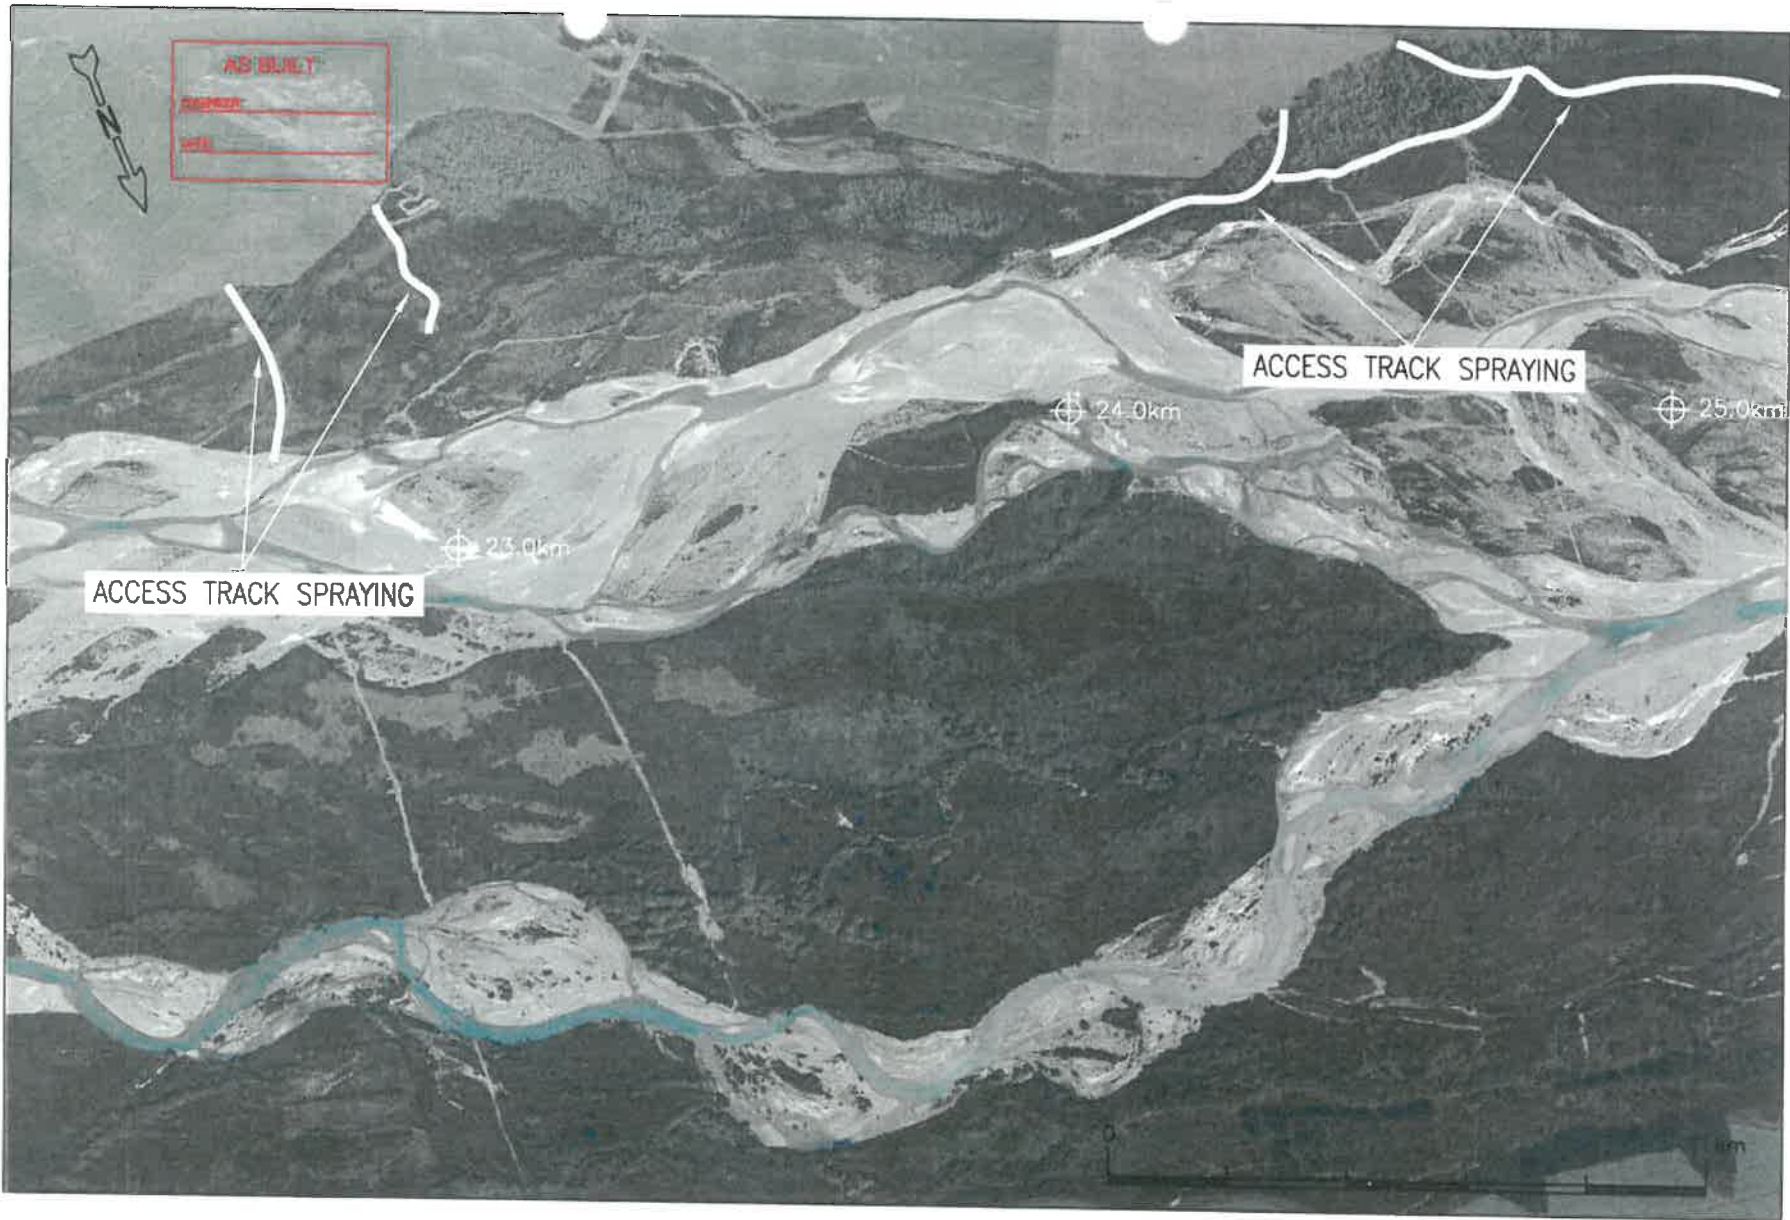



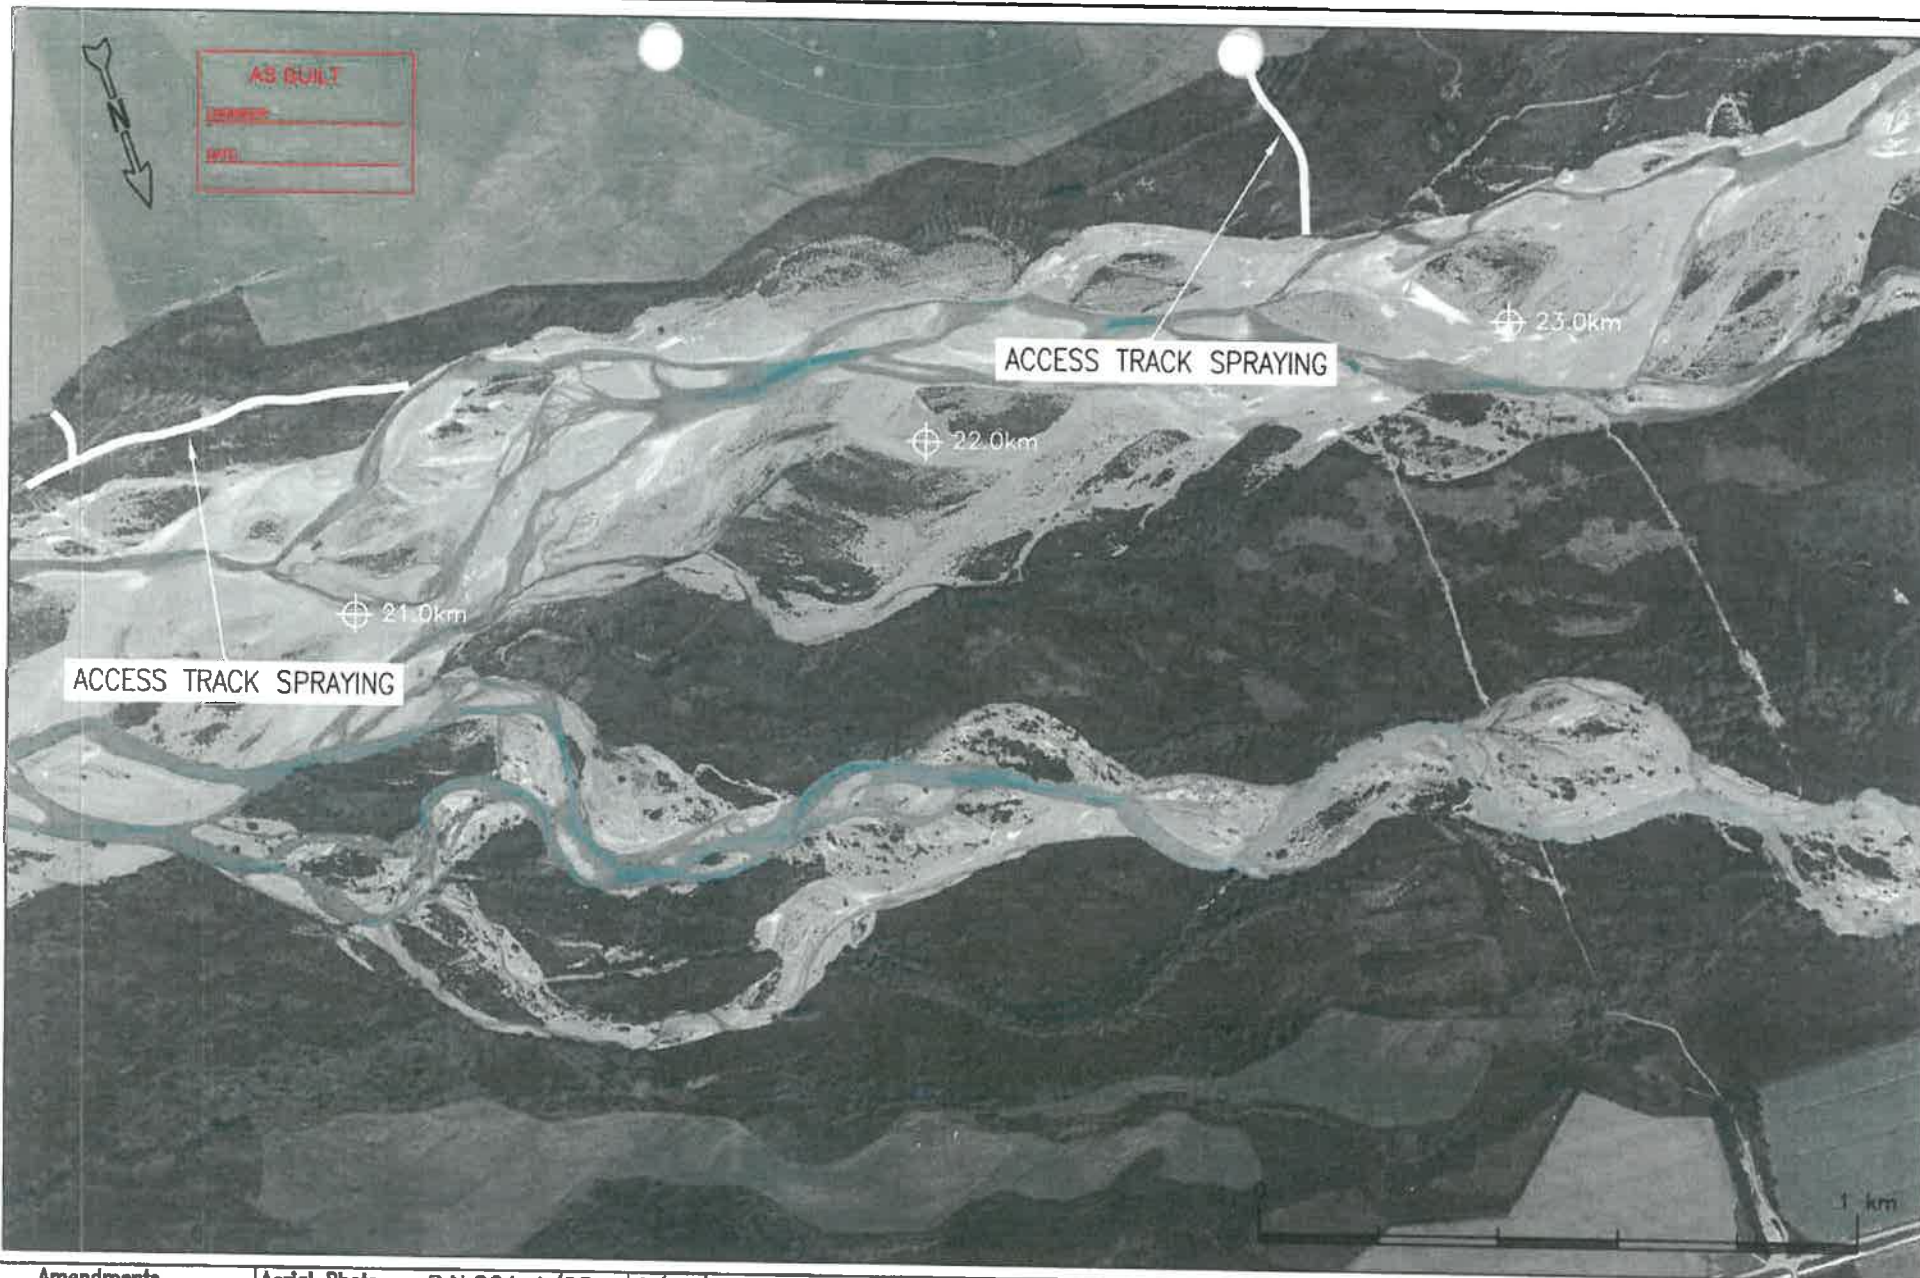
W1	Amendments	Aerial Photo	S.N.264 A/2	2/08	 Environment Canterbury Your Project. Our Work.	Environment Canterbury Rating Districts Works Programme 2011/2012 Rangitata River		Catch No. 6930000 File No. Surv Data 13,563m01 1 of 30	110 PAN
	PLAN ORIGIN E N E N	Designed Complied Checked Recommended	N.F. Daniels	2/08		Original Scale 1:8000 Level Datum			




W13	Amendments	Aerial Photo	S.N.264 A/32	2/08	 Environment Canterbury For regional needs	Environment Canterbury Rating Districts Works Programme 2011/2012 Rangitata River		Catch No. 6930000	110 RAN 13,563m13 13 of 30
	PLAN ORIGIN COORDS	Base Sheet	N.F. Daniels	2/08		Original Scale 1:8000	Level Datum	File No. Surv Data	
		Surveyed							
		Designed							
		Compiled							
		Checked							
		Recommended							





W12_1	Amendments	Aerial Photo	S.N.264 A/30	2/08	 Environment Canterbury <small>For Regional Work</small>	Environment Canterbury Rating Districts Works Programme 2011/2012 Rangitata River	Catch No. 6930000 File No. Surv Data 13,563m12	12 of 30	110 RAN
		Base Sheet	N.F. Daniels	2/08					
PLAN ORIGIN		Designed							
E		Compiled							
		Checked							
		Recommended							




W11_1	Amendments	Aerial Photo	S.N.264 A/28	2/08		Environment Canterbury	Catch No. 6930000 File No. Surv Data	
	PLAN ORIGIN COORDS E N E N	Base Sheet Surveyed Designed Compiled Checked Recommended	N.F. Daniels	2/08		Rating Districts Works Programme 2011/2012 Rangitata River		13,563m11 11 of 30
						Original Scale 1:8000	Level Datum	110 RAN


AS BUILT
 ENGINEER
 DATE

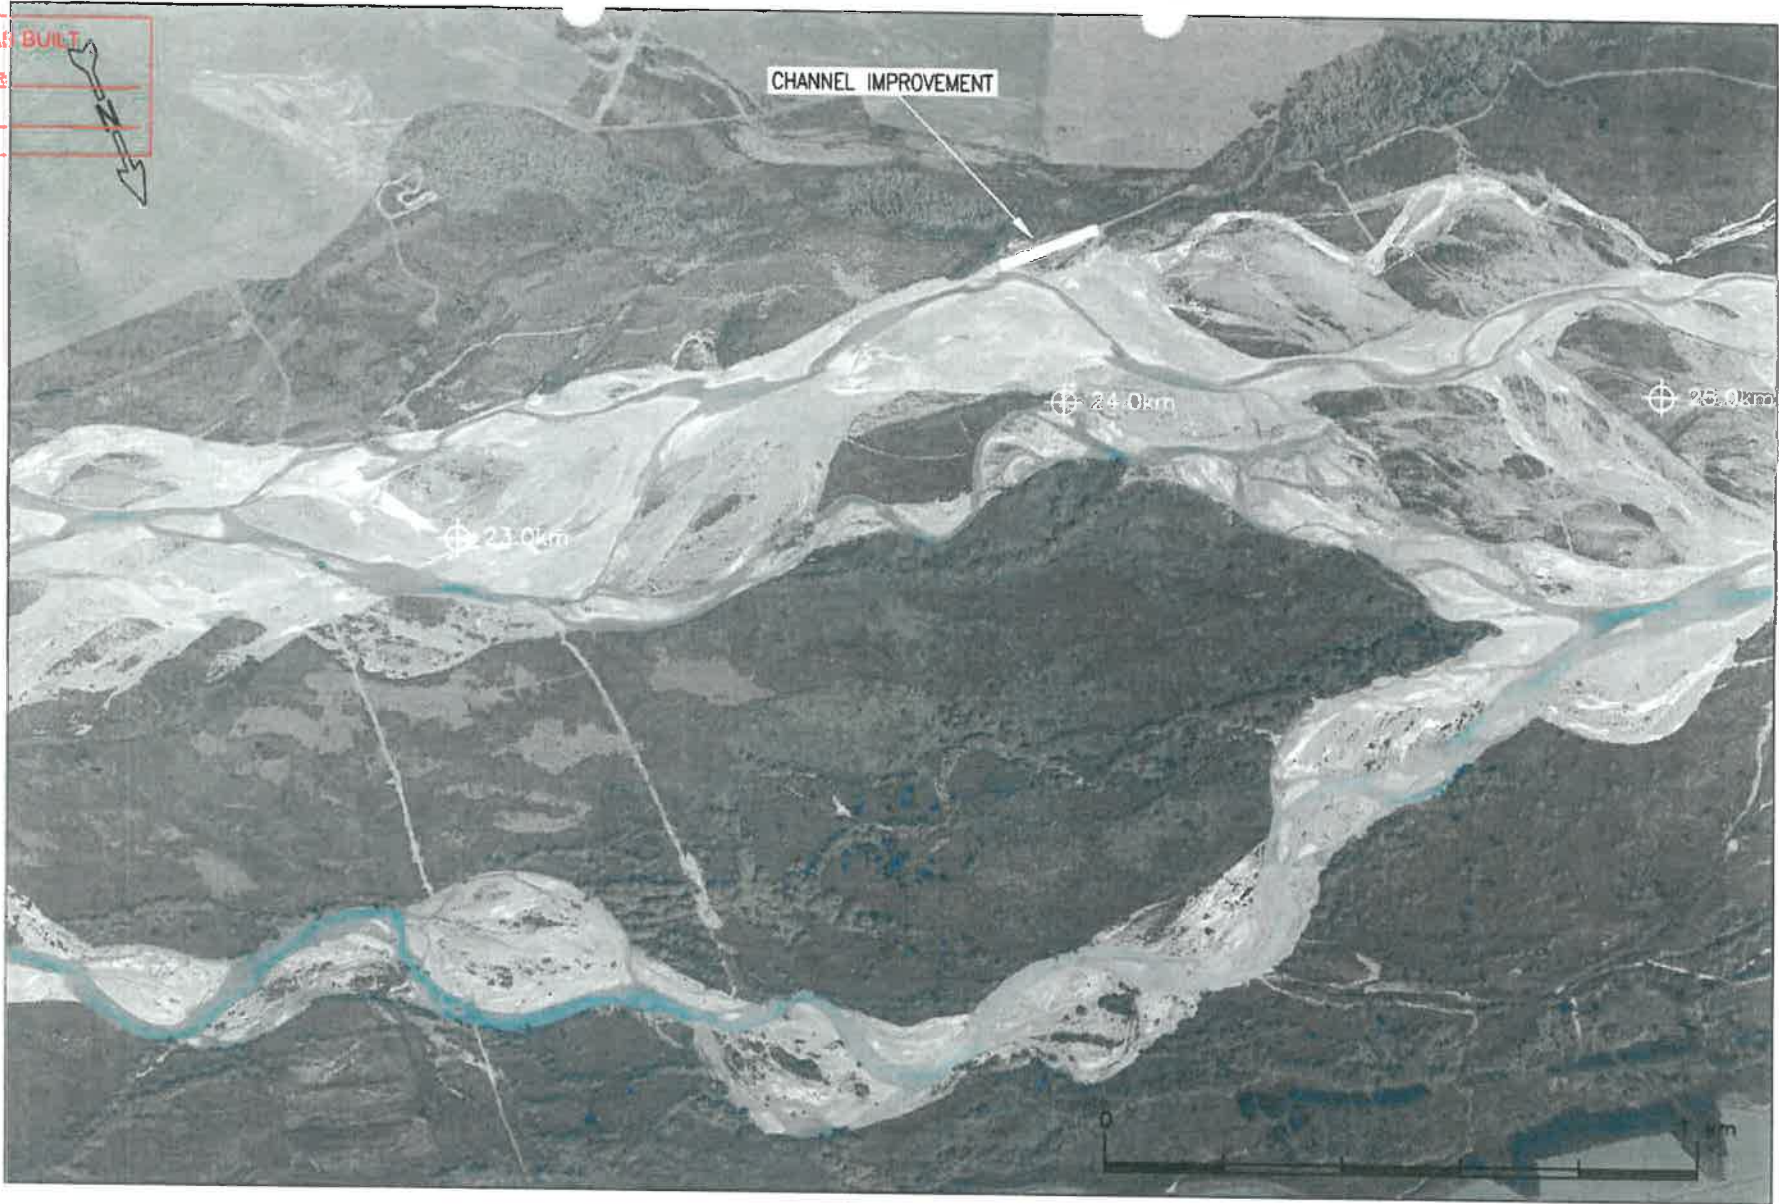

W14_3	Amendments	Aerial Photo Base Sheet	S.N.264 A/30	2/08		Environment Canterbury		Catch No. 6930000
						Rating Districts Works Programme		
PLAN ORIGIN COORDS E N E N		Surveyed Designed Compiled Checked Recommended	N.F. Daniels	2/08		2011/2012		Surv Data
						Rangitata River		
						Original Scale 1:8000	Level Datum	12 of 30

109 RAN

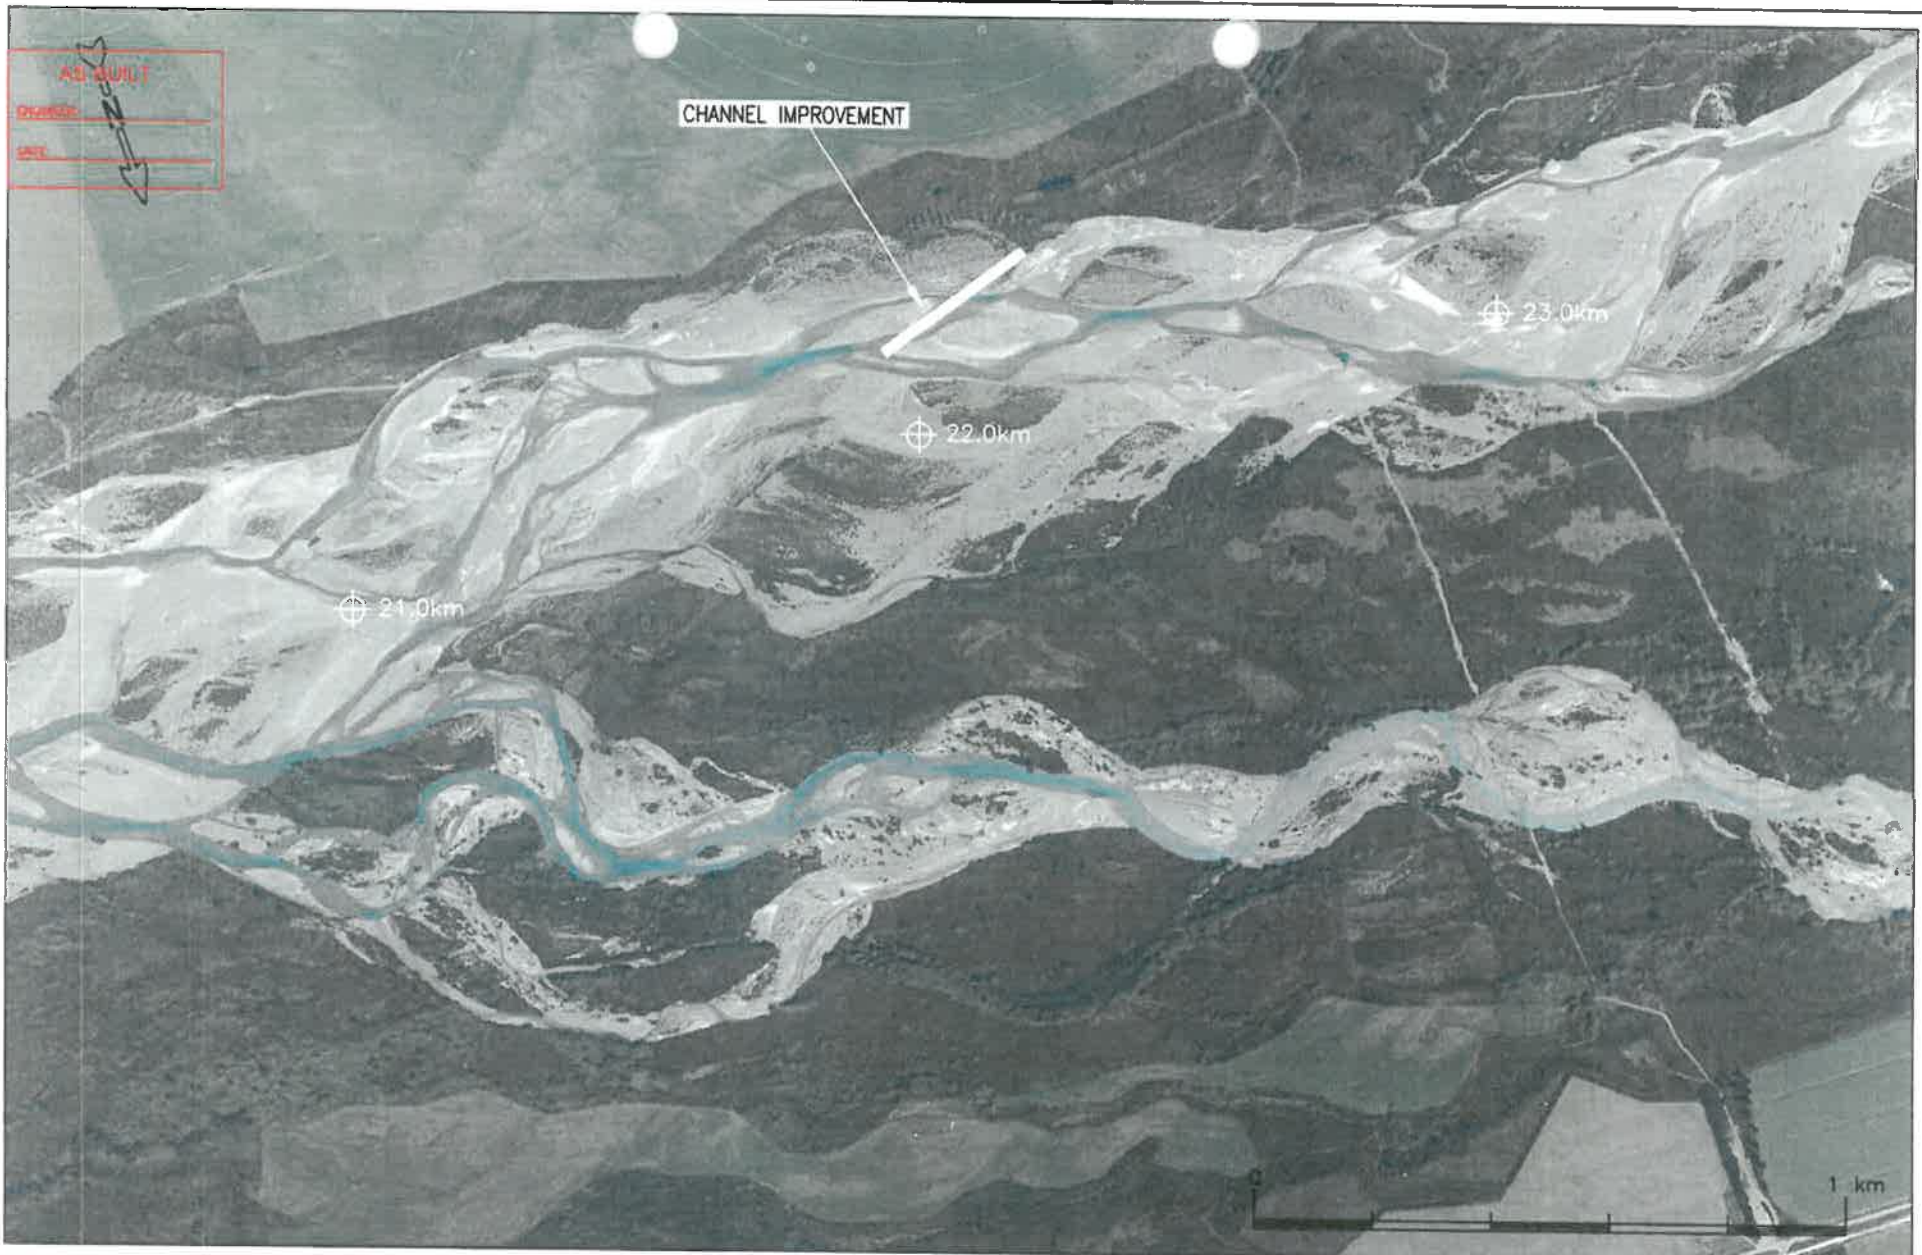

W14_3	Amendments	Aerial Photo	S.N.264 A/28	2/08		Environment Canterbury Rating Districts Works Programme 2011/2012 Rangitata River		Catch No. 6930000	109 RAN 13,563m11 11 of 30
	PLAN ORIGIN COORDS	Base Sheet	N.F. Daniels	2/08		Original Scale 1:8000	Level Datum	File No. Surv Data	
		Surveyed							
		Designed							
		Compiled							
		Checked							
		Recommended							